


ITEM	PART NO.	DESCRIPTION	QTY.
1		REINF. - ENTRANCE DOOR HEADER, FALSE RAFTER TO "D" POST.	1
2		REINF. - ENTRANCE DOOR HEADER TO UPPER WINDSHIELD HEADER.	1
3		REINF. - FOR FIRST STD. RAFTER, 78" H.R.	1
4		REINF. - FOR FIRST STD. RAFTER, 73" H.R.	1

NOTE: SUB-COMPONENTS SHOWN FOR REFERENCE ONLY

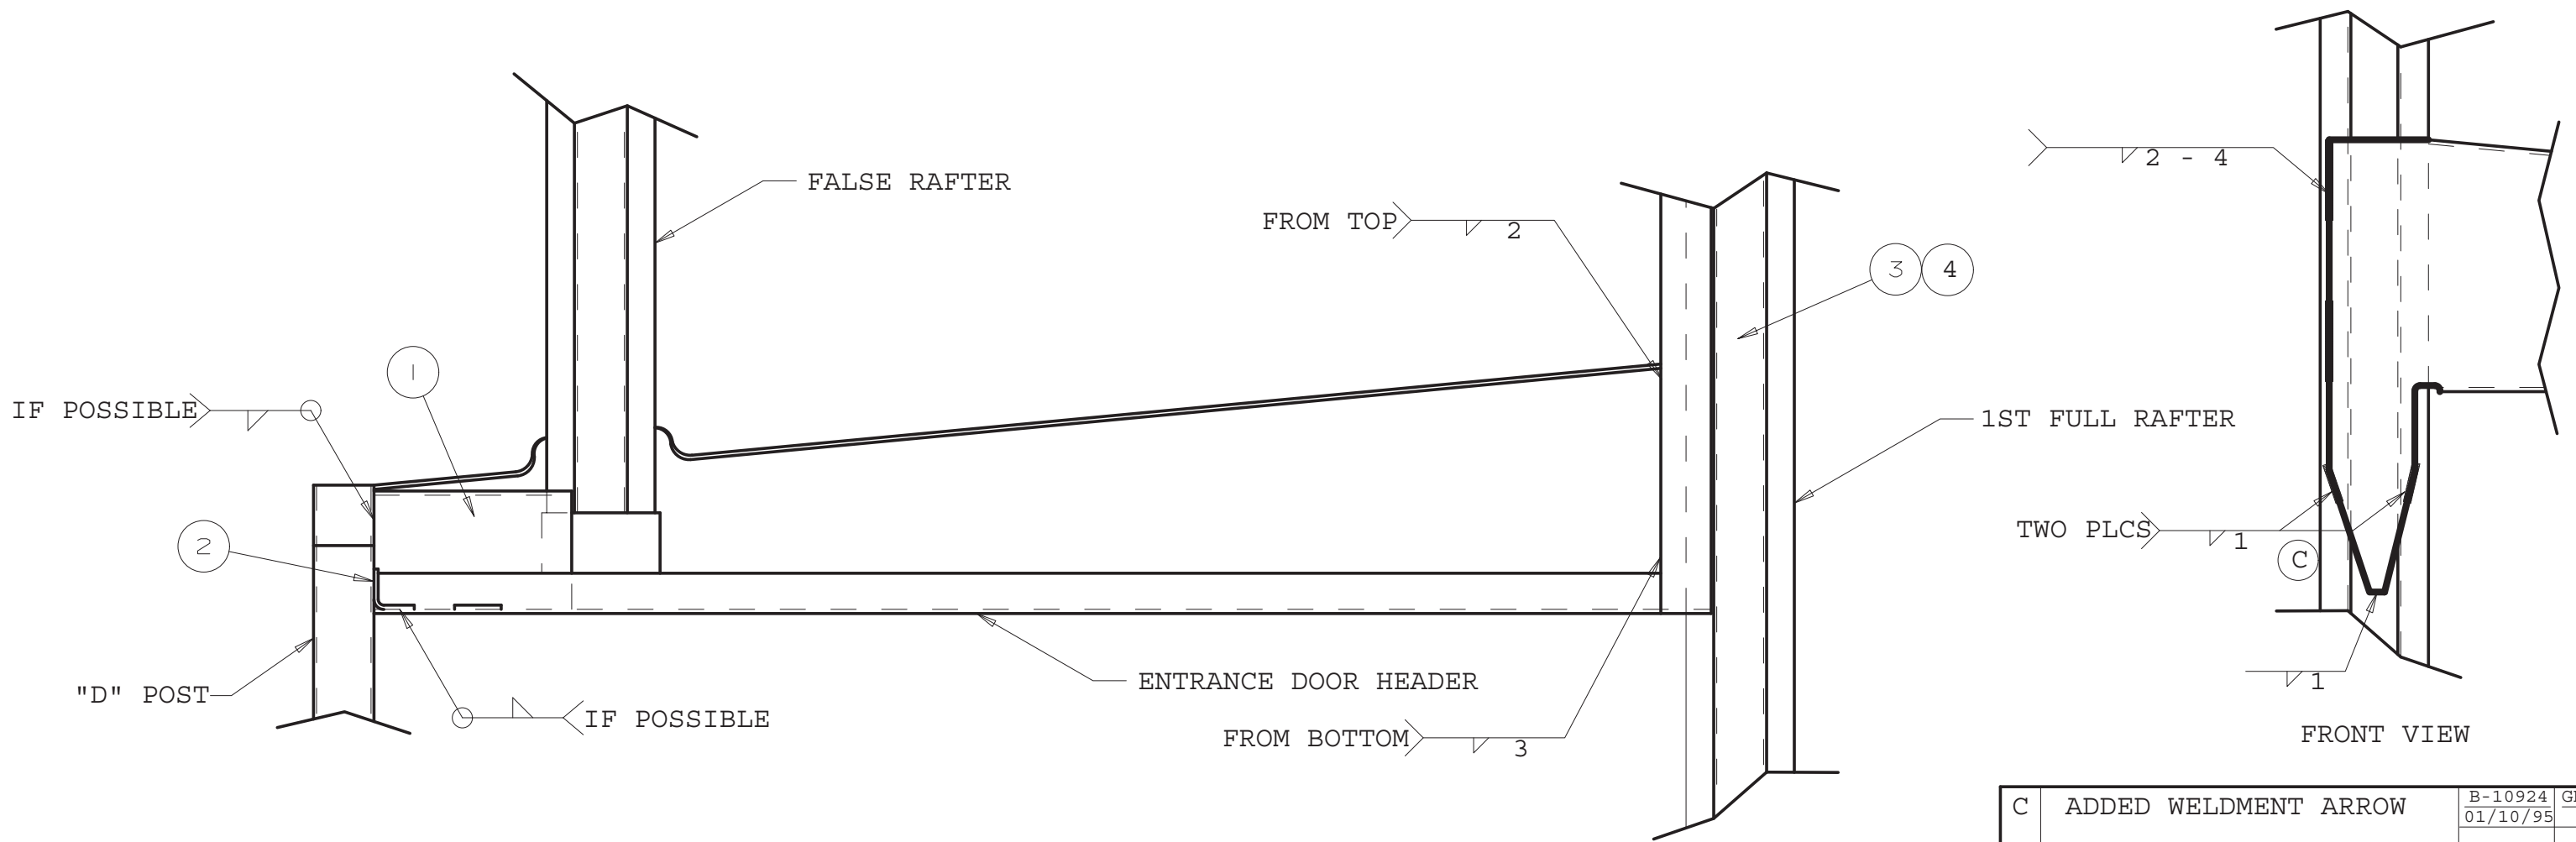

C	ADDED WELDMENT ARROW	B-10924	GDC	LH
		01/10/95		
LET	REVISION	DATE	BY	CF
THOMAS BUILT BUSES, INC.				
HIGH POINT, NC		WOODSTOCK, CANADA		
THIRD ANGLE PROJECTION	TOLERANCE UNLESS OTHERWISE NOTED			
	DECIMAL	FRACTIONAL	ANGULAR	
	.XXX .015	±1/32	±1/2°	
	.XX .03			
	.X .06			
WELDMENT - HEADER, REINF. GUSSETS				
DRN.	10/21/93	BY PTL	MAT'L	
CK'D.	10/21/93	BY GDC	SIZE	DWG. NO.
MFG.		BY	B	58000351
SCALE	1/4			

(REF: 58000351SV)