


QTY.	PART #	DESCRIPTION	#
2	69006266	RUBBER BUMPER	1
2	27162703	SCREW, TAPPING	2

(B)

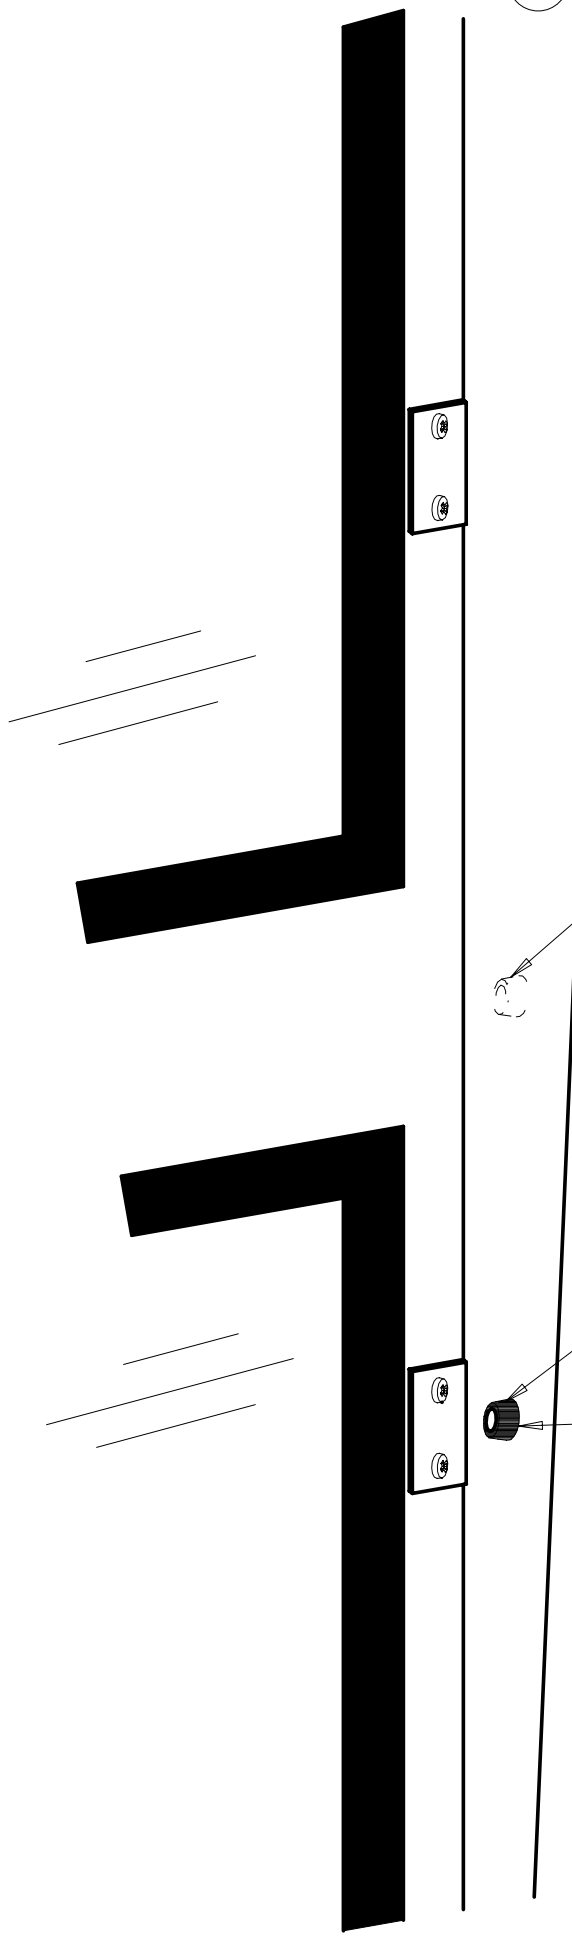

OLD LOCATION OF RUBBER DOOR BUMPER.

RUBBER BUMPER MOVED DOWN TO HINGE. HINGE MUST HIT BUMPER. BOTH SIDES OF DOOR.

1, 2

THIS DRAWING AND ALL INFORMATION PROVIDED WITH IT ARE THE PROPERTY OF THOMAS BUILT BUSES, INC. ANY REPRODUCTION OR DISTRIBUTION OF THIS MATERIAL WITHOUT THE WRITTEN PERMISSION OF THOMAS BUILT BUSES, INC. IS STRICTLY PROHIBITED. COPYRIGHT 1997 THOMAS BUILT BUSES, INC.

THIRD ANGLE PROJECTION		TOLERANCE UNLESS OTHERWISE NOTED			THOMAS BUILT BUSES, INC.		
		DECIMAL	FRACTIONAL	ANGULAR	HIGH POINT, NC WOODSTOCK, CANADA		
		.XXX .015	±1/32	±1/2°	DIAGRAM, DOOR BUMPER LOCATION, O/O DOOR		
B B, WAS 29990004		B-11079	DSW	LH	DRN. 01/31/95 BY DSW MAT'L		
		03/06/95	DSW		CK'D. 1-31-95 BY DSW SIZE DWG. NO.		
					MFG. BY 2A 64004979		
LET	REVISION	DATE	BY	CF	SCALE		